


160 East 65th Street



AS BUILT

160 East 65th Street

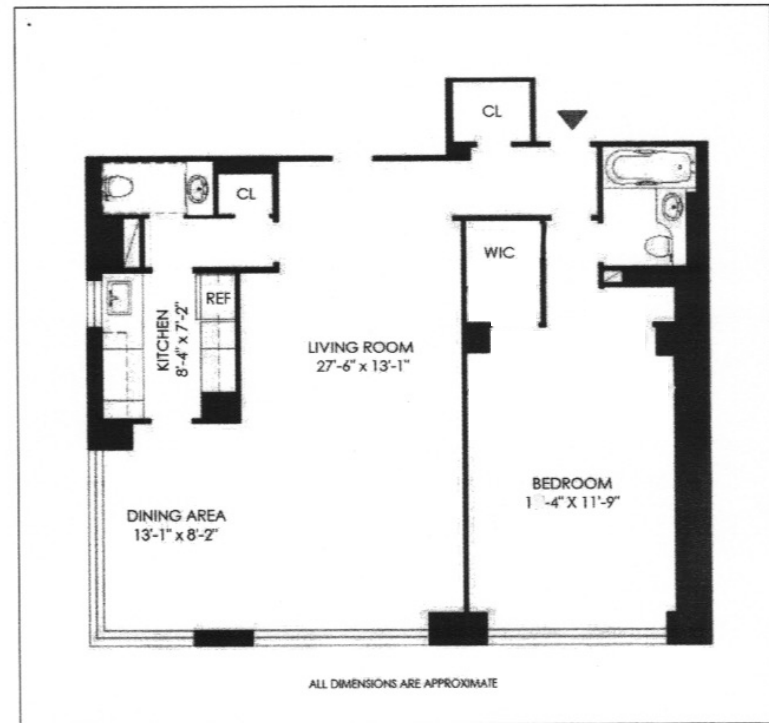

CURRENT LAYOUT